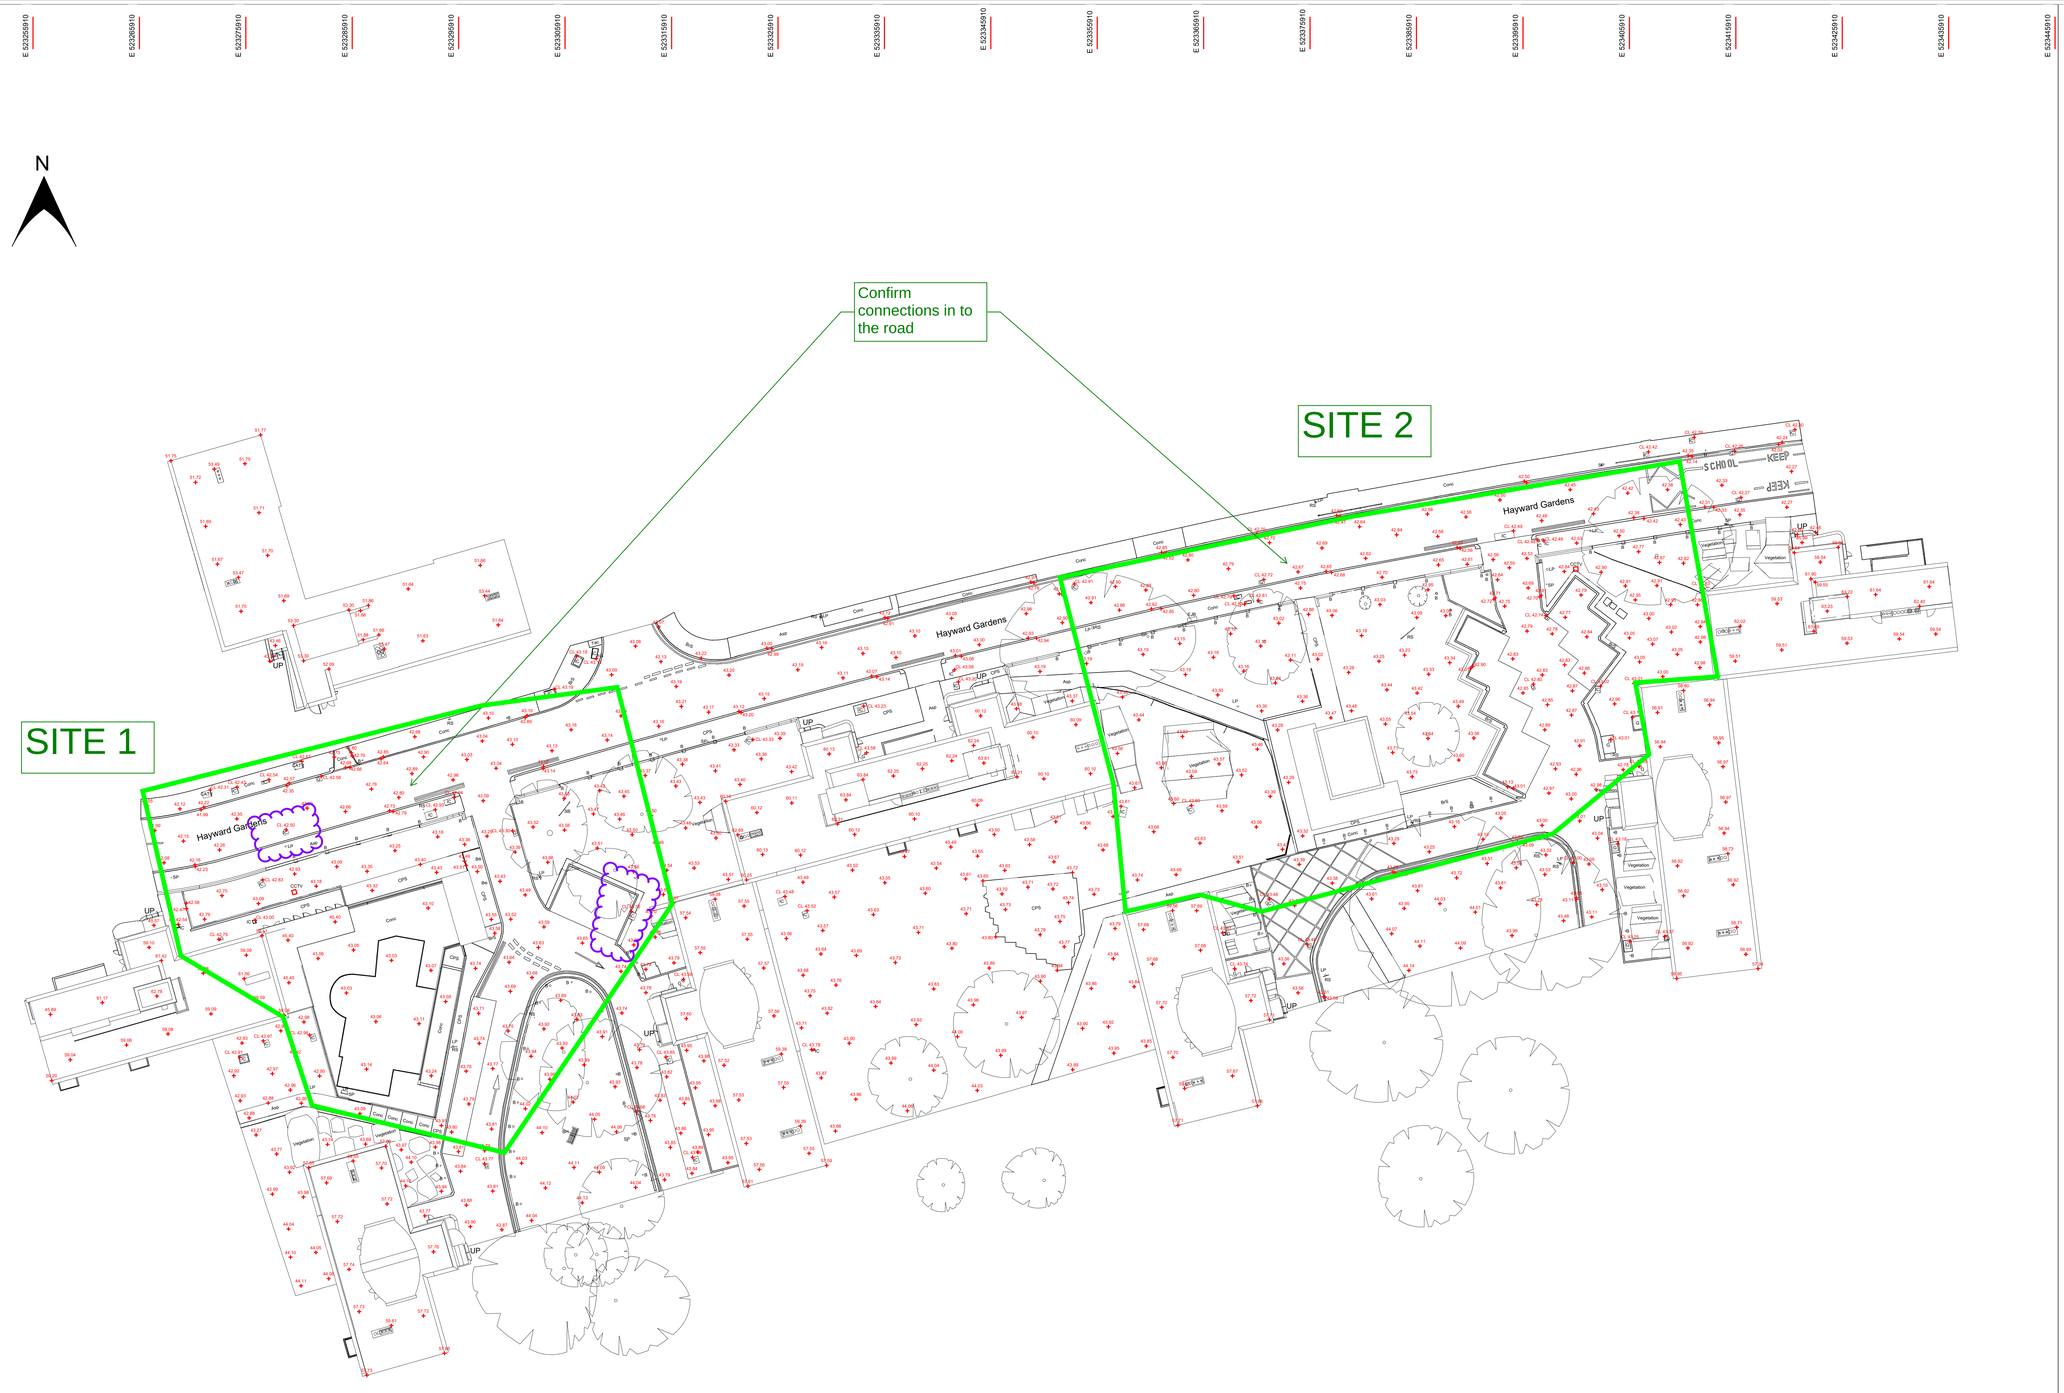

1 Site-Sheet View
1 : 200

EXPORTED FROM REVIT

© PLOWMAN CRAVEN LIMITED
NOT TO BE REPRODUCED WITHOUT PERMISSION

STANDARD ABBREVIATIONS

AC	Air Conditioner	WF	Iron Railing Fence
AH	Arch Height	BT	Illuminated Road Sign
AL	Arch Level	JB	Junction Box
ASH	Arch Spring Height	L	Light
ASL	Arch Spring Level	LB	Litter Bin
B	Bollard	LP	Lamp Post
BGP	Break Glass Point	Mas	Manhole
BH	Beam Height	MH	Manhole
Br	Brick	Mon	Monmuth
BRW	Brick Retaining Wall	OH	Overhead
BSL	Beam Soffit Level	OSBM	Ordonnal Survey Bench Mark
BT	British Telecom	P	Post
BW	Bay Window	PC	Pole Top
CBF	Close Boarded Fence	PLI	Pavement Light
CCTV	Closed Circuit Television	PS	Paving Stones
Chy	Chimney	Rad	Radiator
CL	Cover Level	RDM	Reviewed Door Mat
CLF	Chain Link Fence	RE	Reading Eye
Col	Column	RS	Road Sign
Conc	Concrete	SHR	Shrub Border Plant
CPS	Concrete Paving Slabs	SWP	Soil Water Pipe
CTV	Cable Television IC	s	spread
Cup	Cupboard	S	Window Sill Level/Height
DP	Down Pipe	SBM	Site Bench Mark
DrC	Drainage Channel	SC	Stop Cock
EIC	Electrical Inspection Cover	SH	Spring Height
EL	Electricity Junction Box	SP	Soil Pipe/Vent
EM	Electricity Meter	SL	Skylight
ER	Earthing Rod	SO	Smoke Outlet
ESC	Electrical Switchgear	SP	Sign Post
FA	Fire Alarm	SS	Security Sensor
FB	Flower Bed	SV	Stop Valve
FE	Fire Extinguisher	T	Telephone
FH	Fire Hydrant	Tac	Tactile Paving
FHR	Fire Hose Reel	TBM	Temporary Bench Mark
FL	Floor Level	TCB	Telephone Call Box
FS	Floodlight	TIC	Telephone Inspection Cover
g	girth	TJB	Telephone Junction Box
G	Gully	TL	Traffic Light
GC	Gas Cock	TLCB	Traffic Light Control Box
GM	Gas Meter	TP	Telephone Junction Cover
GV	Gas Valve	TP	Telephone Pole
H	Window Head Height/Level	Typ	Typical
h	Height	V	Vent
HB	Hand Basin	VP	Vent Pipe
HR	Handrail	WH	Water Heater
IC	Inspection Cover	WM	Water Meter
IL	Invert Level	WV	Water Valve

LEGEND

- Floor to ceiling height
- Floor to false ceiling height
- Ceiling level
- False ceiling level
- Stair/step arrows point up
- Sloping ceiling arrows point up
- Roof arrows point down
- Assumed detail

The identification of service covers has been made by a surface inspection only - critical identifications should be verified by the lifting of covers or a full utilities survey.

Due to the inherent instability of paper materials, drawings plotted on paper may be stretched and distorted - dimensions scaled from paper plots should therefore be treated with caution.

This drawing has been produced for the purpose of the original commissioning agent. Plowman Craven Limited will accept no responsibility for details that are subsequently found to be the consequence of undisclosed facts or that were obscured from view at the time of survey or that have been altered since the survey. All data remains the property of Plowman Craven Limited until full payment has been received.

See www.plowmancraven.co.uk for full terms and conditions of contract.

ISSUES & REVISIONS

Issue	Details	By	Date
P01	First Issue - Annotations	PCL	18.10.2022
P02	Updated Annotations	PCL	14.11.2022
P03	Updated Annotations	PCL	15.11.2022

This survey is commensurate with band E accuracy, as outlined in the RICS survey detail accuracy banding table.

Unless otherwise stated, levels have been taken to finished floor surface.
All quoted dimensions are in metres.

Drawing units are millimetres.

CLIENT

Pollard Thomas Edwards
Hayward
Gardens,London
SW15 3BZ

PROJECT TITLE

BIM Ashburton

Site plan

PRESENTATION SCALE 1:200 @ A0

DATE OF ORIGINAL SURVEY August 2022

PC PROJECT No. 47656 CHECKED BY IK

DRAWING No. ISSUE

47656-PCL-HG-ZZ-DR-G -001 P03

Plowman Craven

Plowman Craven House
2 Lea Business Park
Lower Luton Road
Harpenden
Hertfordshire
AL5 5EQ

115 Southwark Bridge Road
London
SE1 0AX

Tel: +44 (0)1582 765566
Email: post@plowmancraven.co.uk
Web: www.plowmancraven.co.uk

Tel: +44 (0)207 490 7700